



Date: Jan 18, 2008

EXHIBIT B
Pressure Testing Permit*

Type of Test [] Hydrostatic [] Pneumatic

Test Pressure 90 psig Maximum Allowable Working Pressure 30 psig

Items to be Tested

Proof test for TPC Signa Feed-through clamped between two 6" ISO Flanges. For T962 test. See Attached drawings of test vessel week of Jan 22, 2008.

Location of Test

PAB Calibration Shop Date and Time

Hazards Involved

rupture and Flying debris. Total pressurized volume is relatively small.

Safety Precautions Taken

Place Test vessel in garbage can in PAB Calibration Shop. Personal kept out of Calibration Shop or behind barrier. See attached procedure and markup MP-194470

Special Conditions or Requirements

Qualified Person and Test Coordinator
Dept/Date

Robert Sanders or Jim Tweed

Division/Section Safety Officer
Dept/Date

ERIC MATHUGH 13747N
PD/ESH 2.07.08

Results

Test was successful.

Witness

[Signature]
(Safety Officer or Designee)

Dept/Date

PD/ESH 2.07.08


* Must be signed by division/section safety officer prior to conducting test. It is the responsibility of the test coordinator to obtain signatures.

Pressure Testing Procedure


T962 Signal Feed-Through Assembly

NOTE: all valve numbers are listed on drawing MD-194470

- (1) Use relief valve SV-123 set at 110 psi to protect the system during the pressure test.
- (2) Install test vessel inside garbage can on South side of Calibration shop test stand.
- (3) Connect test vessel to MV-107-H using 1/4" copper or stainless tubing or polyflow tubing (120 psig working pressure).
- (4) Lock or rope off outside door to calibration shop. Post "*Pressure Test In Progress, Do Not Enter*" signs on both doors to the calibration shop, visible to the outside.
- (5) During pressure test personnel to remain behind test stand or outside of Calibration shop.
- (6) Pressurize test vessel to 15 psi and see if pressure holds for 2 minutes. If pressure does not hold use snoop to leak check joints. Fix leaks and repeat. Do not pressurize more than 15 psi during this process.
- (7) Pressure in order, to each of the following pressures and hold for 1 minute. If pressure fails to hold repeat step 6:
 - 30 psi
 - 60 psi
 - 90 psi
- (8) Bleed off pressure in test vessel to 30 psi, snoop all joints on test vessel. Inspect for deformation.
- (9) Bleed off pressure to 0 psi. Remove the electronic card from test vessel and inspect for deformation or damage.

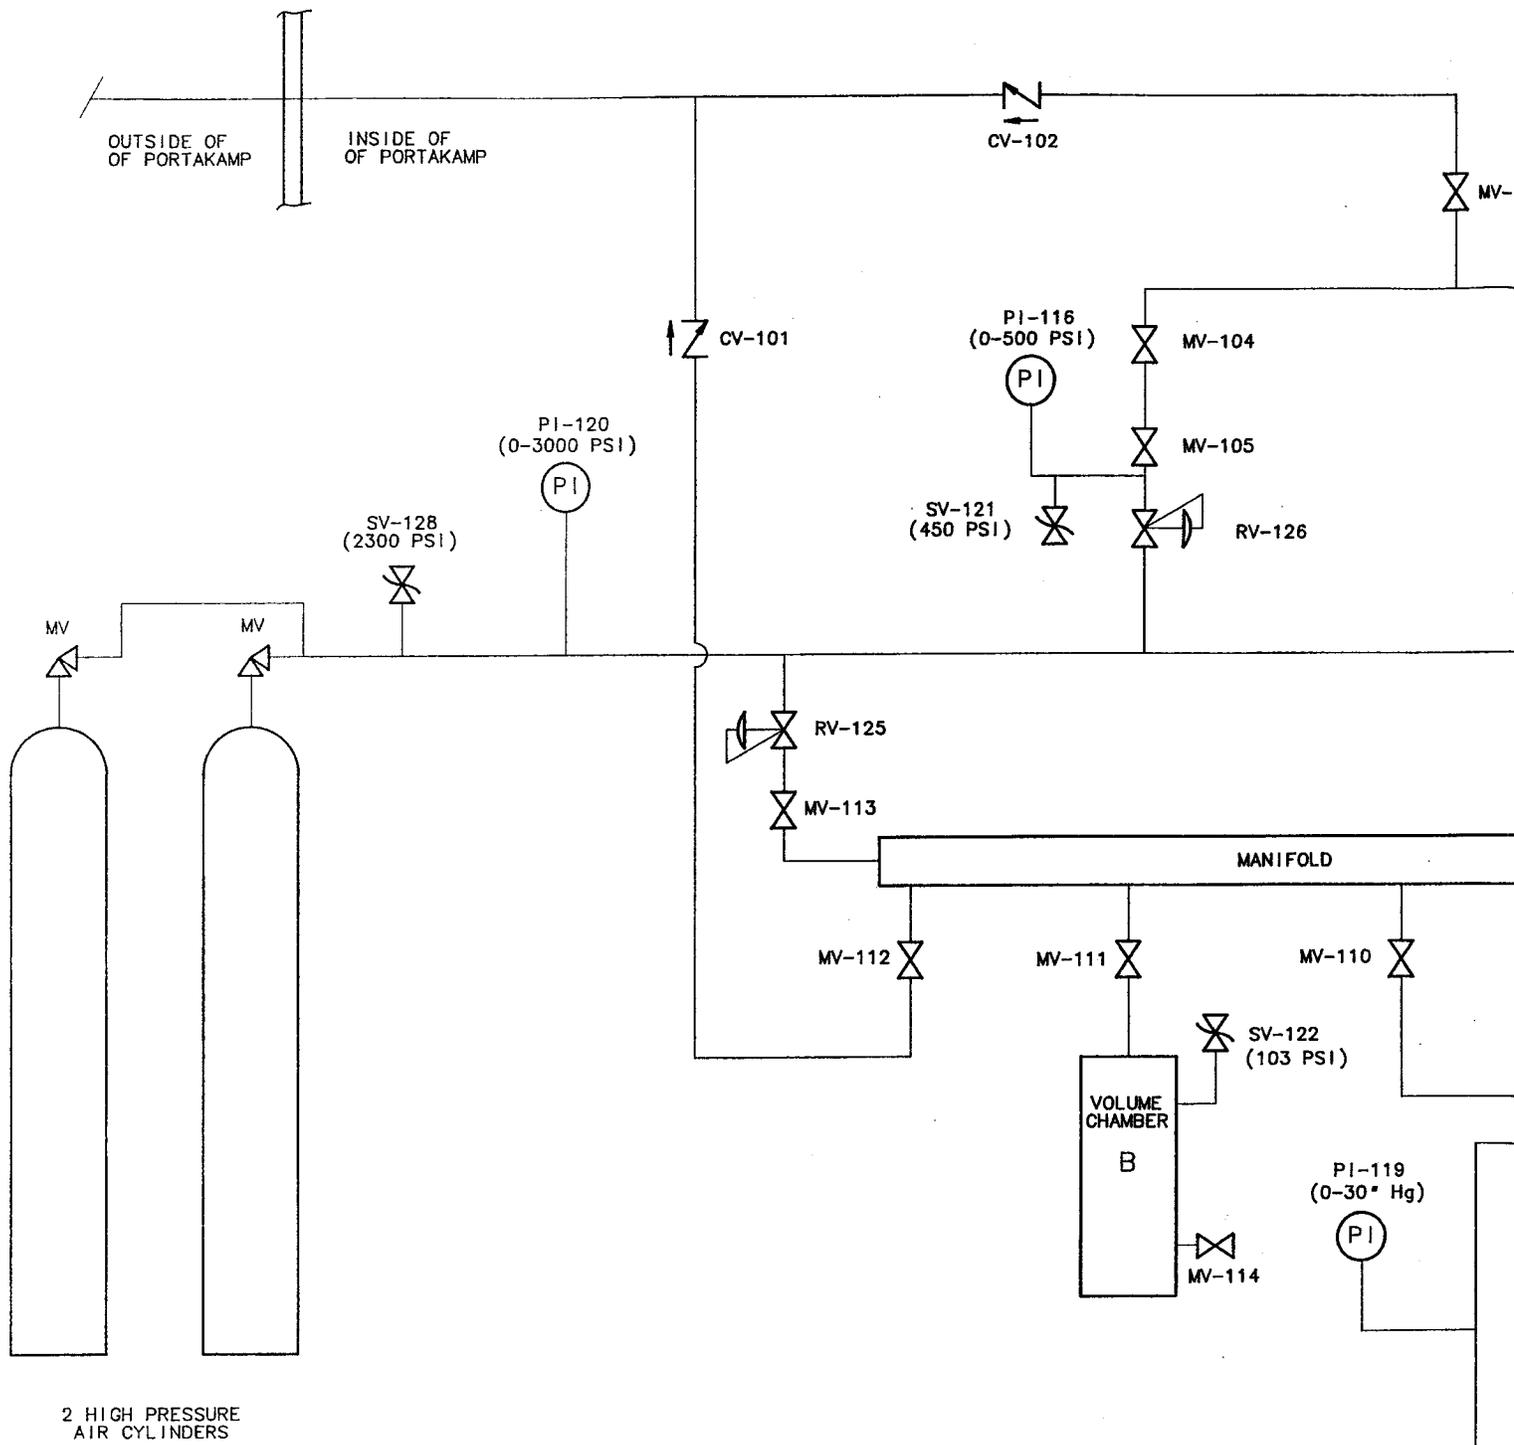


REV.	DESCRIPTION	DRAWN	DATE
A	CHANGED VALVE DESCRIPTIONS	RCH	6/92
		C NILA	6/29/92
B	ADDED EXTRA TANK	RCH	7/92
		C NILA	7/02/92
C	REVISED SYMBOLS FOR VALVES CV-101, CV-102, MV-125, MV-126, MV-127, AND GAS CYL. MV., ADDED NOTE TO CYL.	VIC M	10/22/92
		<i>[Signature]</i>	10-22-92

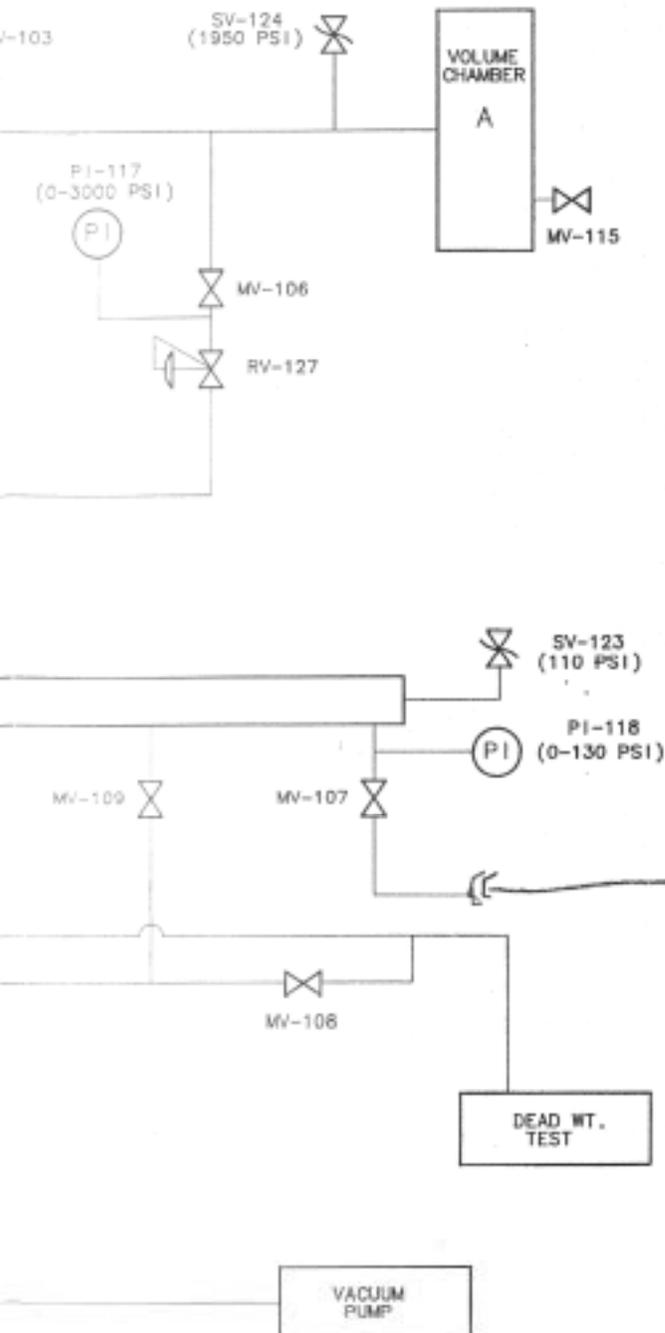

Pressure Test
 Set up for T962
 SIGNAL FEEDTHROUGH

$\frac{1}{4}$ " SS or copper or polyflour tubing

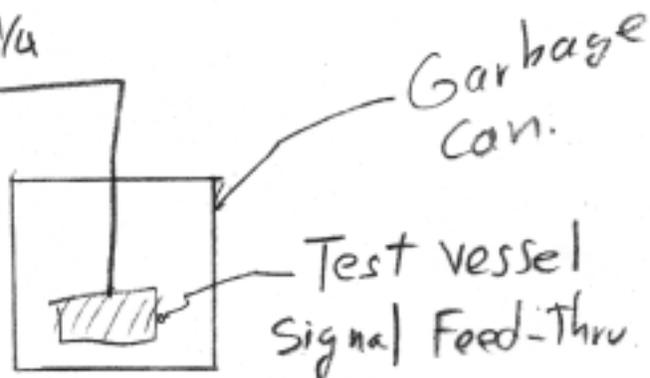

ITEM NO.	PART NO.	DESCRIPTION OR SIZE	QTY. REQ.
PARTS LIST			
UNLESS OTHERWISE SPECIFIED		ORIGINATOR	J DOMOLECZNY 5/92
FRACTIONS	DECIMALS	ANGLES	DRAWN
±	-	±	R HATING 5/92
			CHECKED
			C NILA 5/22/92
1. BREAK ALL SHARP EDGES 1/64 MAX.		APPROVED	
2. DO NOT SCALE DIMS.		USED ON	
3. DIMENSIONS IN ACCORD WITH ANSI Y14.5 STD'.		MATERIAL	
✓ MAX. ALL MACHINED SURFACES			D
FERMI NATIONAL ACCELERATOR LABORATORY UNITED STATES DEPARTMENT OF ENERGY			
RD/CRYOGENICS DEPT. RELIEF VALVE TEST PANEL			
SCALE	DRAWING NUMBER	SHEET NO.	REV.
NONE	MD-194470	1	C